



SUITE 230  
AS-BUILT PLAN - 1 OF 1  
5600 VANGUARD - LEVEL TWO  
2,088 USF / 2,380 RSF  
SCALE: 1/8" = 1'-0"  
DATE: OCTOBER 25, 2005

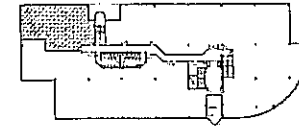

KEY PLAN

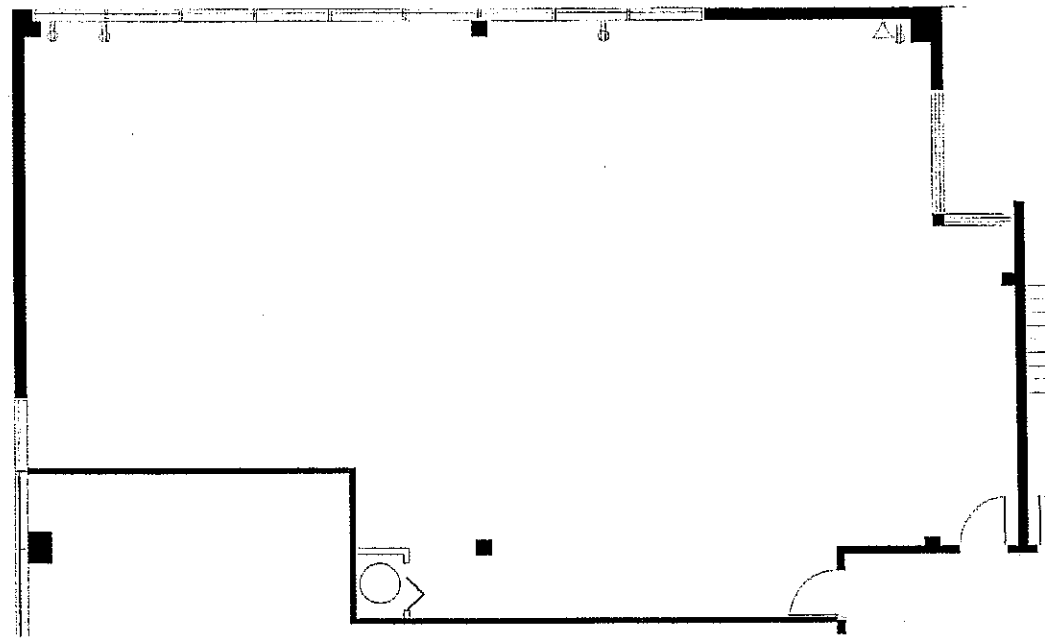

5600



SMITH  
HARRIS  
DESIGN  
ASSOCIATES